



WILLIAM A. KIBBE & ASSOCIATES, INC.
ENGINEERS | ARCHITECTS | SURVEYORS

ADDENDUM NO. 1

PROJECT: WILLIAMS CHARTER TOWNSHIP
S. GARFIELD TO W. FISHER ROAD WATER MAIN
AND SANITARY SEWER

OWNER: WILLIAMS CHARTER TOWNSHIP

ARCHITECT: WILLIAM A. KIBBE & ASSOCIATES, INC.

PROJECT LOCATION: S. GARFIELD TO W. FISHER ROAD

DATE: JULY 30, 2025

WAK PROJECT NO. 25-1247- 0021

A. INSTRUCTIONS:

1. The Construction Documents dated July, 2025 (Issued for Bid) for the above referenced project are modified as noted in this Addendum.
2. All work performed under this document shall be subject to the General Conditions of the Contract and Specifications for similar work in connection with this project.

B. CLARIFICATIONS

Item #1 – All Sanitary Sewer piping to be minimum SDR 26.

Item #2 – Added reference drawing #177 for existing watermain along the west side of S. Garfield Road.

Item #3 – Added reference drawing #68 for existing sanitary sewer along the west side of S. Garfield Road.

Engineer's Opinion of Probable Construction Costs are as follows:
Watermain est. \$238,000. Sanitary Sewer est. \$256,000.


C. CHANGES TO SPECIFICATIONS:

1. None

D. CHANGES TO DRAWINGS

1. **Re-issued Drawing C2.0:** Please note benchmark change/clarification. Applies to all plan sheets.
2. **Re-issued Drawing C3.1:** Please note added 1" water service lead at Sta. 4+24.
3. **Re-issued Drawing C3.2:** Please note added 1" water service lead at Sta. 10+79, and restoration of existing rip rap is called out as "incidental to construction".
4. **Re-issued Drawing C4.0:** Please note removal and replacement of existing south drive to Tri-City Equipment Rental, 5024 Garfield Rd, Auburn, MI 48611.
5. **Re-issued Drawing C4.1:** Please note added 6" sanitary sewer service lead at Sta. 4+65, and restoration of existing rip rap is called out as "incidental to construction".
6. **Re-issued Drawing C4.2:** Please note added 6" sanitary sewer service leads at Sta. 8+90, and Sta. 11+50. Changed manhole rim at Sta. 11+50.

END OF ADDENDUM No. 1

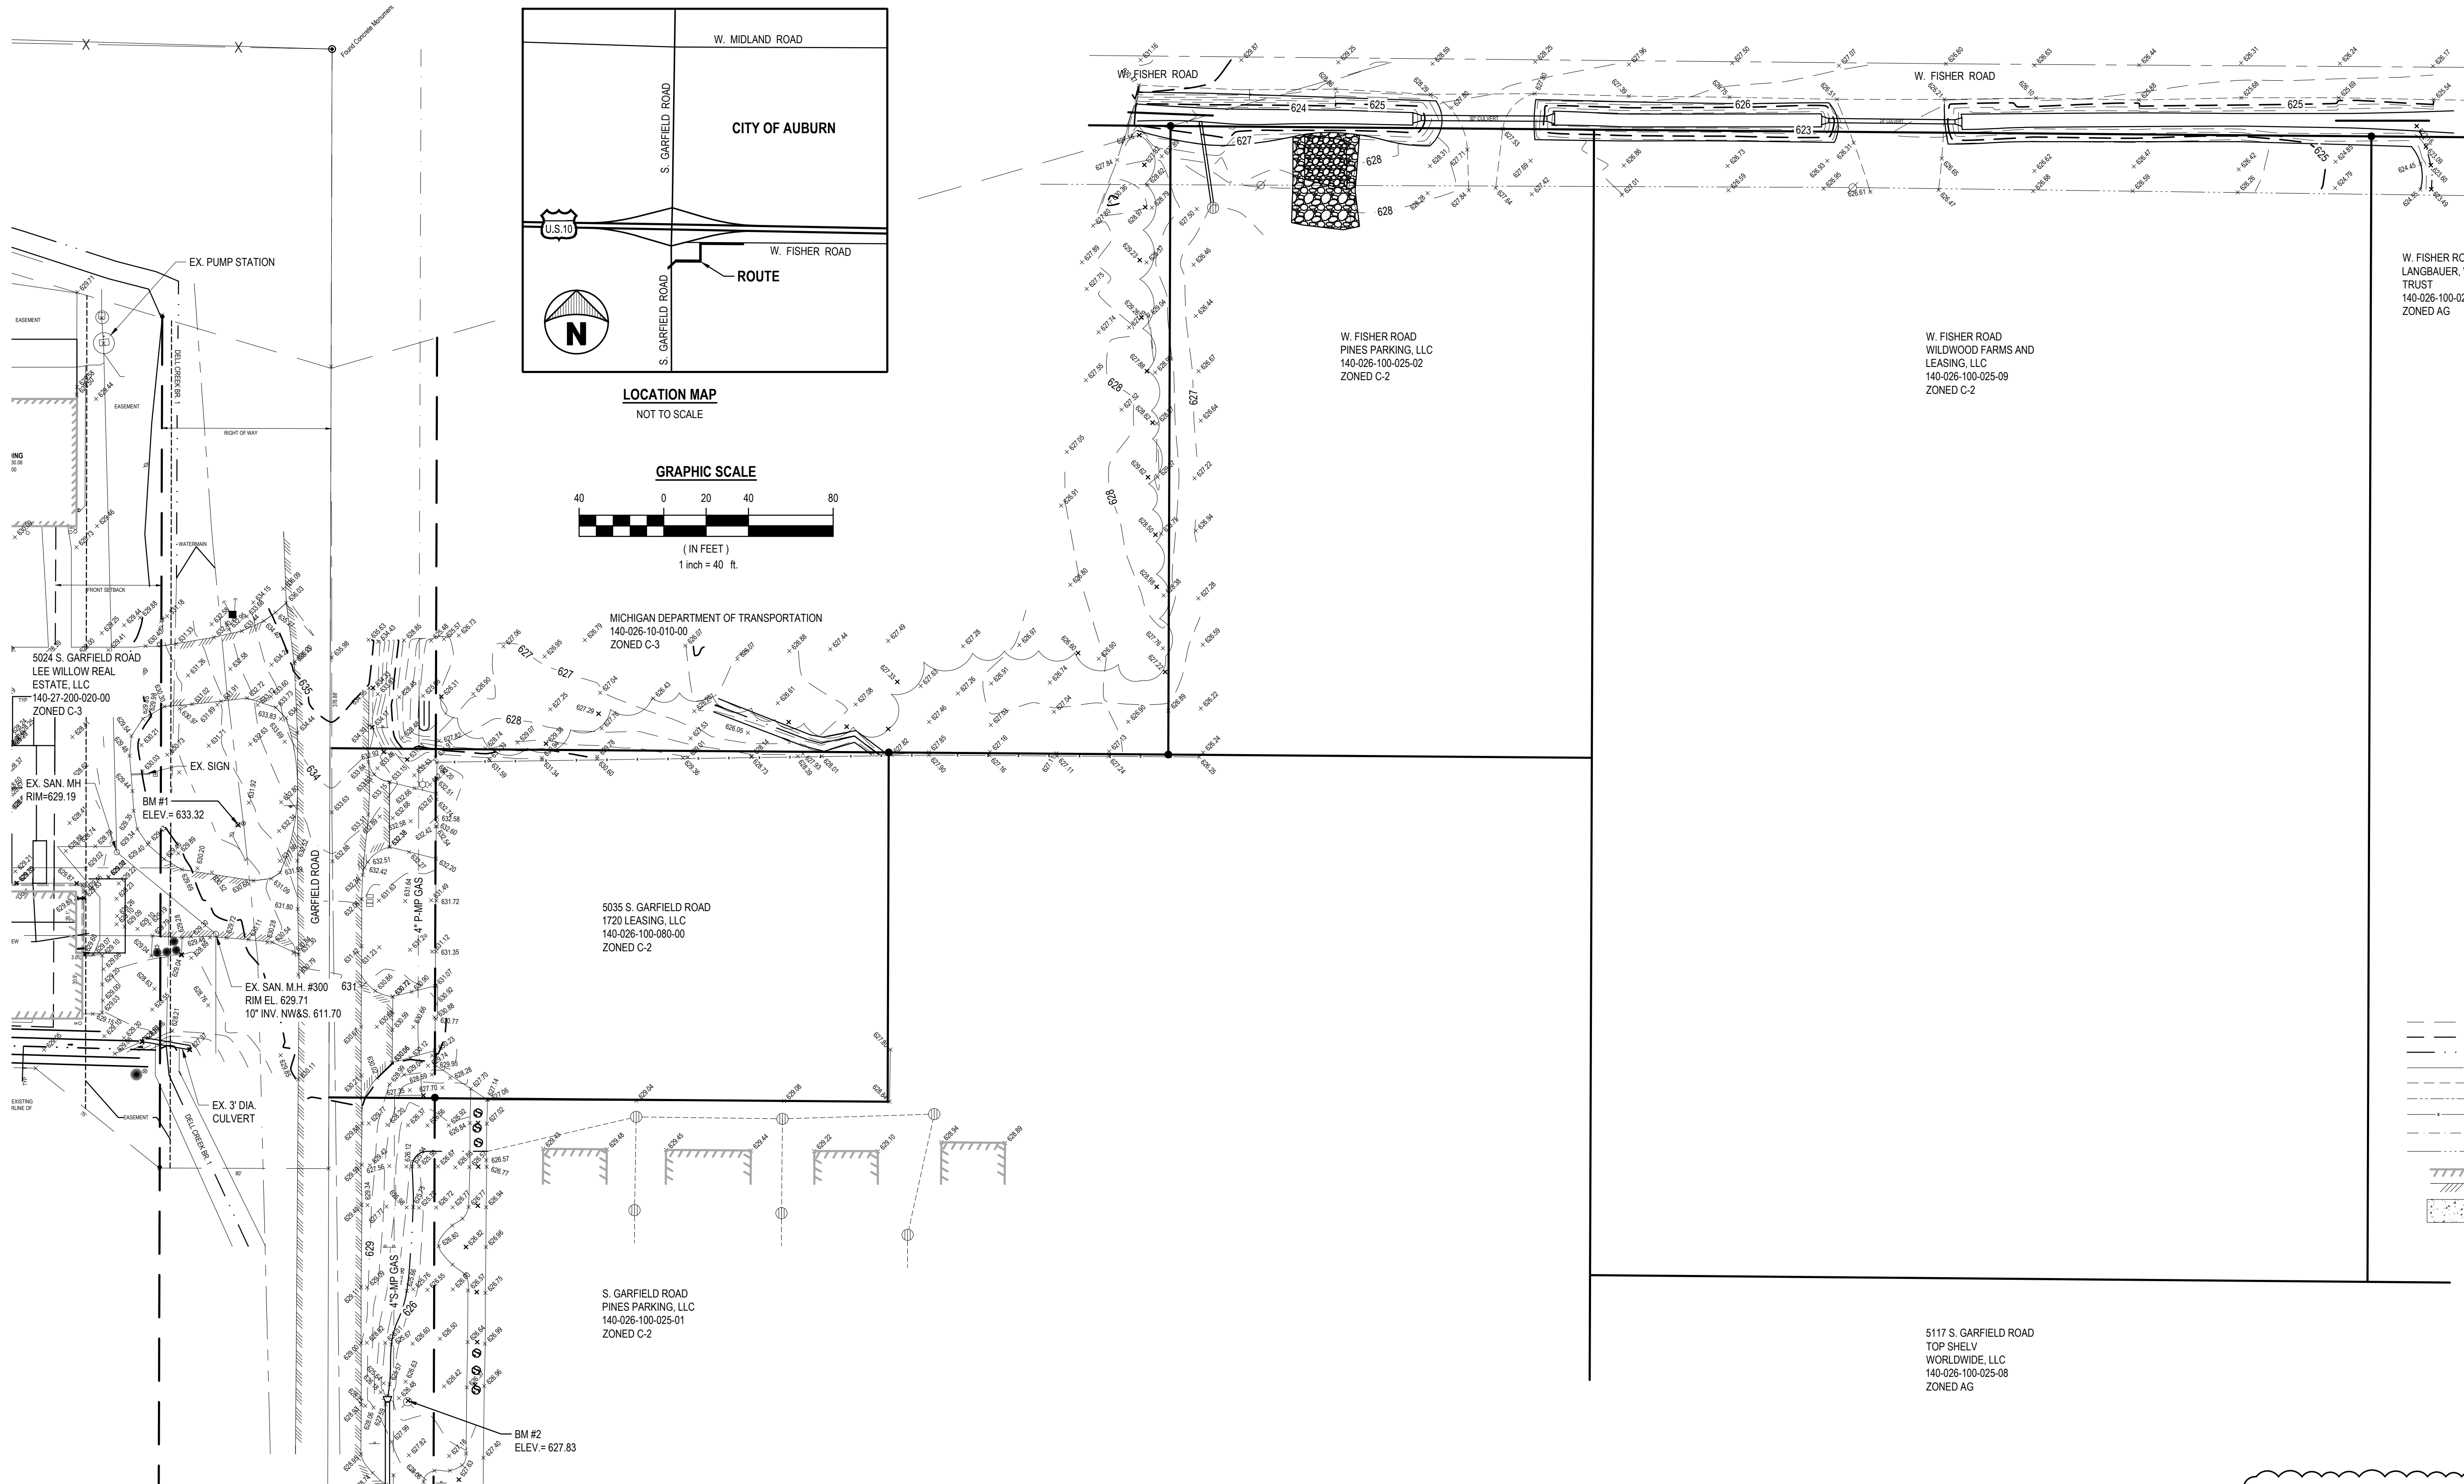

EXISTING SITE PLAN AND TOPOGRAPHIC SURVEY

SCALE: 1" = 40'



Know what's below.
Call before you dig.

LEGEND

- EX. SPOT GRADE
- EX. MINOR CONTOUR
- EX. MAJOR CONTOUR
- EX. CENTERLINE DITCH
- EX. SANITARY SEWER W/ MANHOLE
- EX. STORM SEWER
- EX. WATERMAIN
- EX. CHAINLINK FENCE
- EX. GAS LINES
- EX. OVERHEAD UTILITY WIRES
- EX. BUILDINGS
- EX. BITUMINOUS PAVEMENT
- EX. CONCRETE PAVEMENT
- EX. SIGN WITH POST
- EX. STORM CURB INLET
- EX. STORM CATCH BASIN/MANHOLE
- EX. SANITARY MANHOLE
- EX. HYDRANT
- EX. WATER OR GAS VALVE
- EX. UTILITY POLE
- EX. LIGHT POLE
- EX. UTILITY RISER
- EX. MAILBOX

BENCHMARK

- NO. 1 - NORTHEAST FLANGE BOLT ON HYDRANT 44' WEST OF GARFIELD ROAD CENTERLINE AT 5024 S. GARFIELD ROAD. ELEVATION 633.32 (NAVD 88 DATUM)
- NO. 2 - NORTHEAST FLANGE BOLT ON HYDRANT 33' EAST OF GARFIELD ROAD CENTERLINE AT PARCEL 140-026-100-025-01. ELEVATION 627.83 (NAVD 88 DATUM)

UTILITY NOTE

THE UTILITY LOCATIONS AS HEREIN SHOWN ARE BASED ON FIELD OBSERVATIONS AND A CAREFUL REVIEW OF MUNICIPAL AND UTILITY RECORDS. HOWEVER, IT IS NOT POSSIBLE TO DETERMINE THE PRECISE SIZE, LOCATION, DEPTH, PRESSURE, OR ANY OTHER CHARACTERISTICS OF UNDERGROUND UTILITIES, TANKS OR SEPTIC FIELDS WITHOUT EXCAVATION. THEREFORE, WE CANNOT GUARANTEE THE ACCURACY OF COMPLETENESS OF THE BURIED UTILITY INFORMATION HEREIN SHOWN. THE CONTRACTOR SHALL CALL "MISS DIG" AT (811) A MINIMUM OF THREE WORKING DAYS PRIOR TO ANY EXCAVATION. IT SHALL BE THE RESPONSIBILITY OF THE CONTRACTOR TO VERIFY THESE LOCATIONS PRIOR TO CONSTRUCTION AND MAKE EVERY EFFORT TO PROTECT AND/OR RELOCATE THEM AS REQUIRED. THE CONTRACTOR SHALL NOTIFY THE ENGINEER OF DESIGN AS SOON AS POSSIBLE IN THE EVENT A DISCREPANCY IS FOUND.





WILLIAMS CHARTER TOWNSHIP
SANITARY SEWER & WATERMAIN EXTENSION
W. FISHER ROAD
AUBURN, MI

EXISTING SITE PLAN AND TOPOGRAPHIC SURVEY



DATE	07/23/25
STATUS / REVISIONS	
ISSUED FOR BIDS	07/30/25
ADDENDUM #1	
NO.	1
CHECKED BY:	J. WHEELER
DESIGNED BY:	D.W. BANASZAK
DRAWN BY:	D.W. BANASZAK
PROJ. #:	25-1247-0021

SHEET
C2.0

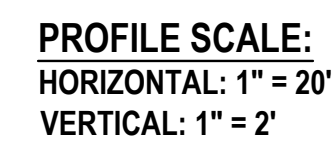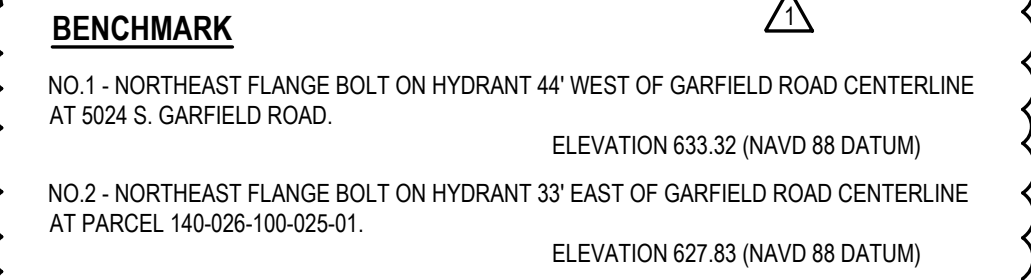

SHEET
3.1

PRINTED: 7/30/2025 4:17:13 PM

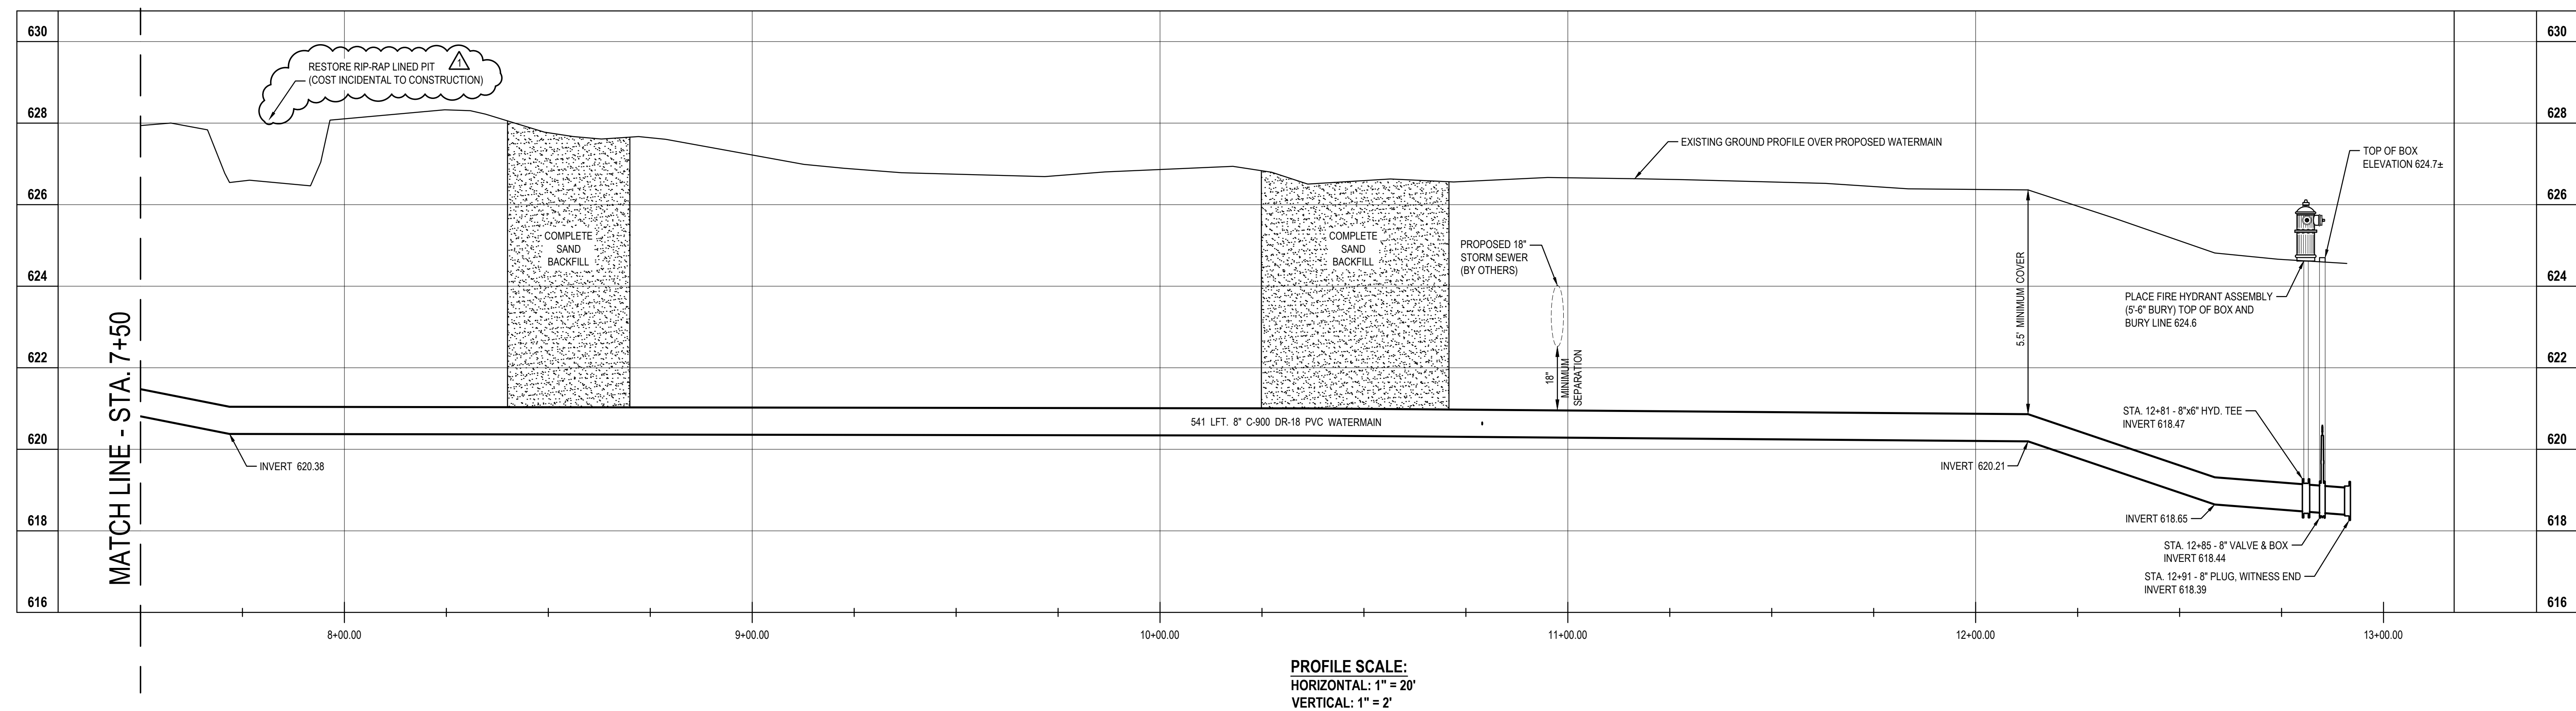
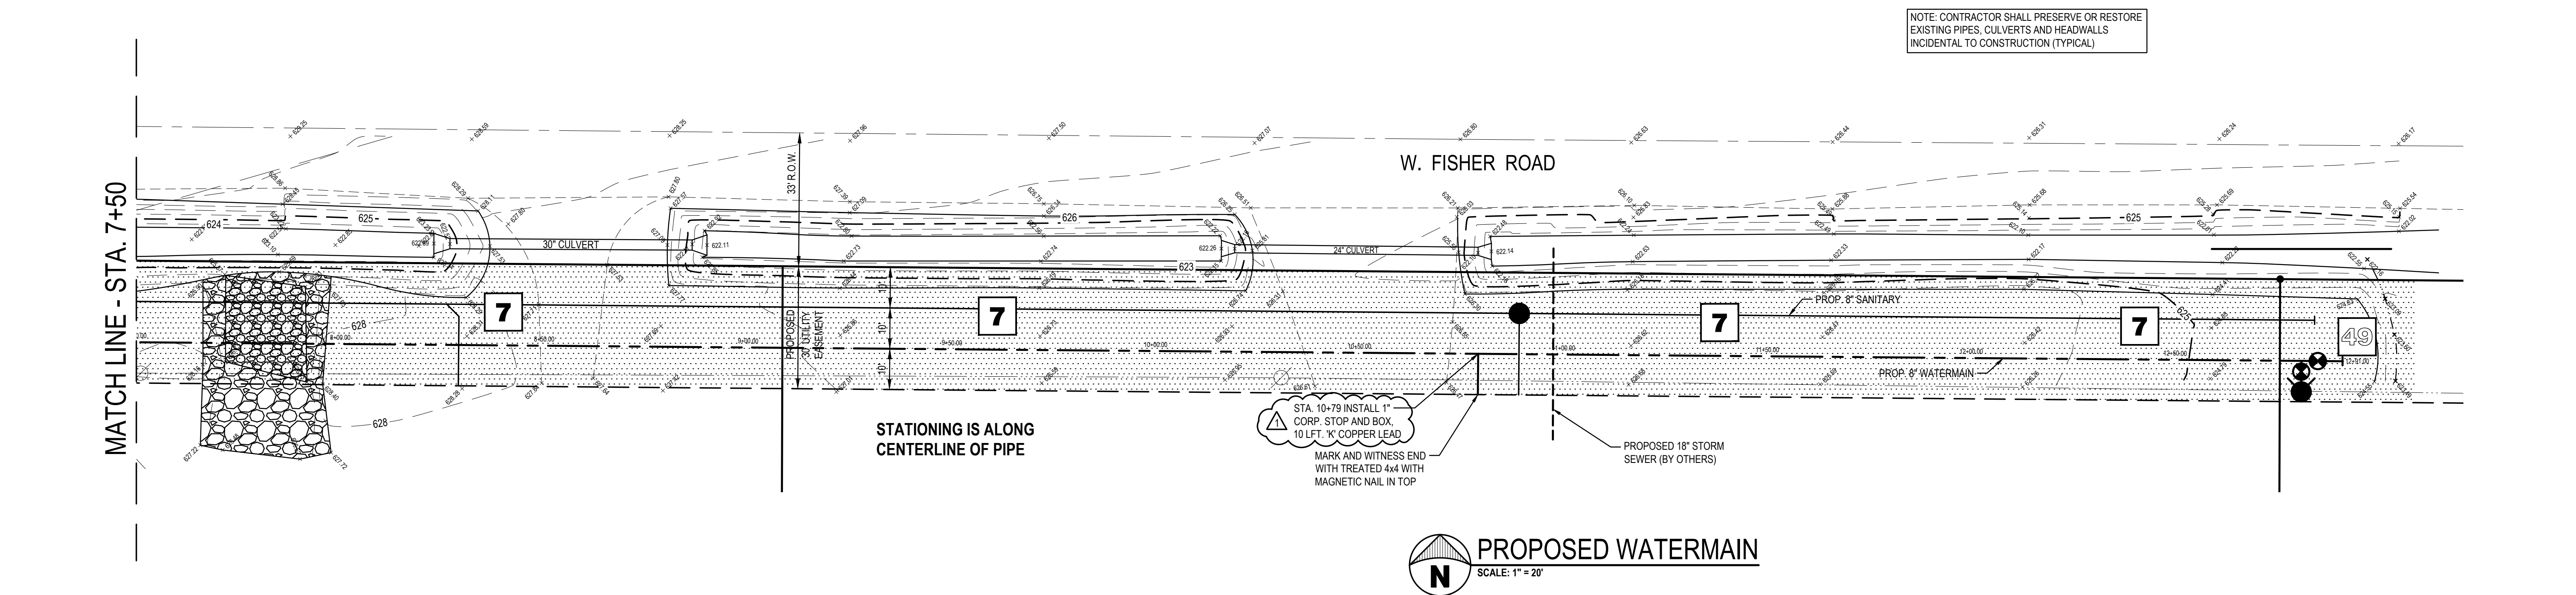


Know what's **below**.
Call before you dig.

<u>BENCHMARK</u>	
NO.1 - NORTHEAST FLANGE BOLT ON HYDRANT 44' WEST OF GARFIELD ROAD CENTERLINE AT 5024 S. GARFIELD ROAD.	ELEVATION 633.32 (NAVD 88 DATUM)
NO.2 - NORTHEAST FLANGE BOLT ON HYDRANT 33' EAST OF GARFIELD ROAD CENTERLINE AT PARCEL 140-026-100-025-01.	ELEVATION 627.83 (NAVD 88 DATUM)

WILLIAMS CHARTER TOWNSHIP
SANITARY SEWER & WATERMAIN EXTENSION
W. FISHER ROAD

PROPOSED SANITARY SEWER
PLAN AND PROFILE STA. 0+00 TO STA. 4+75

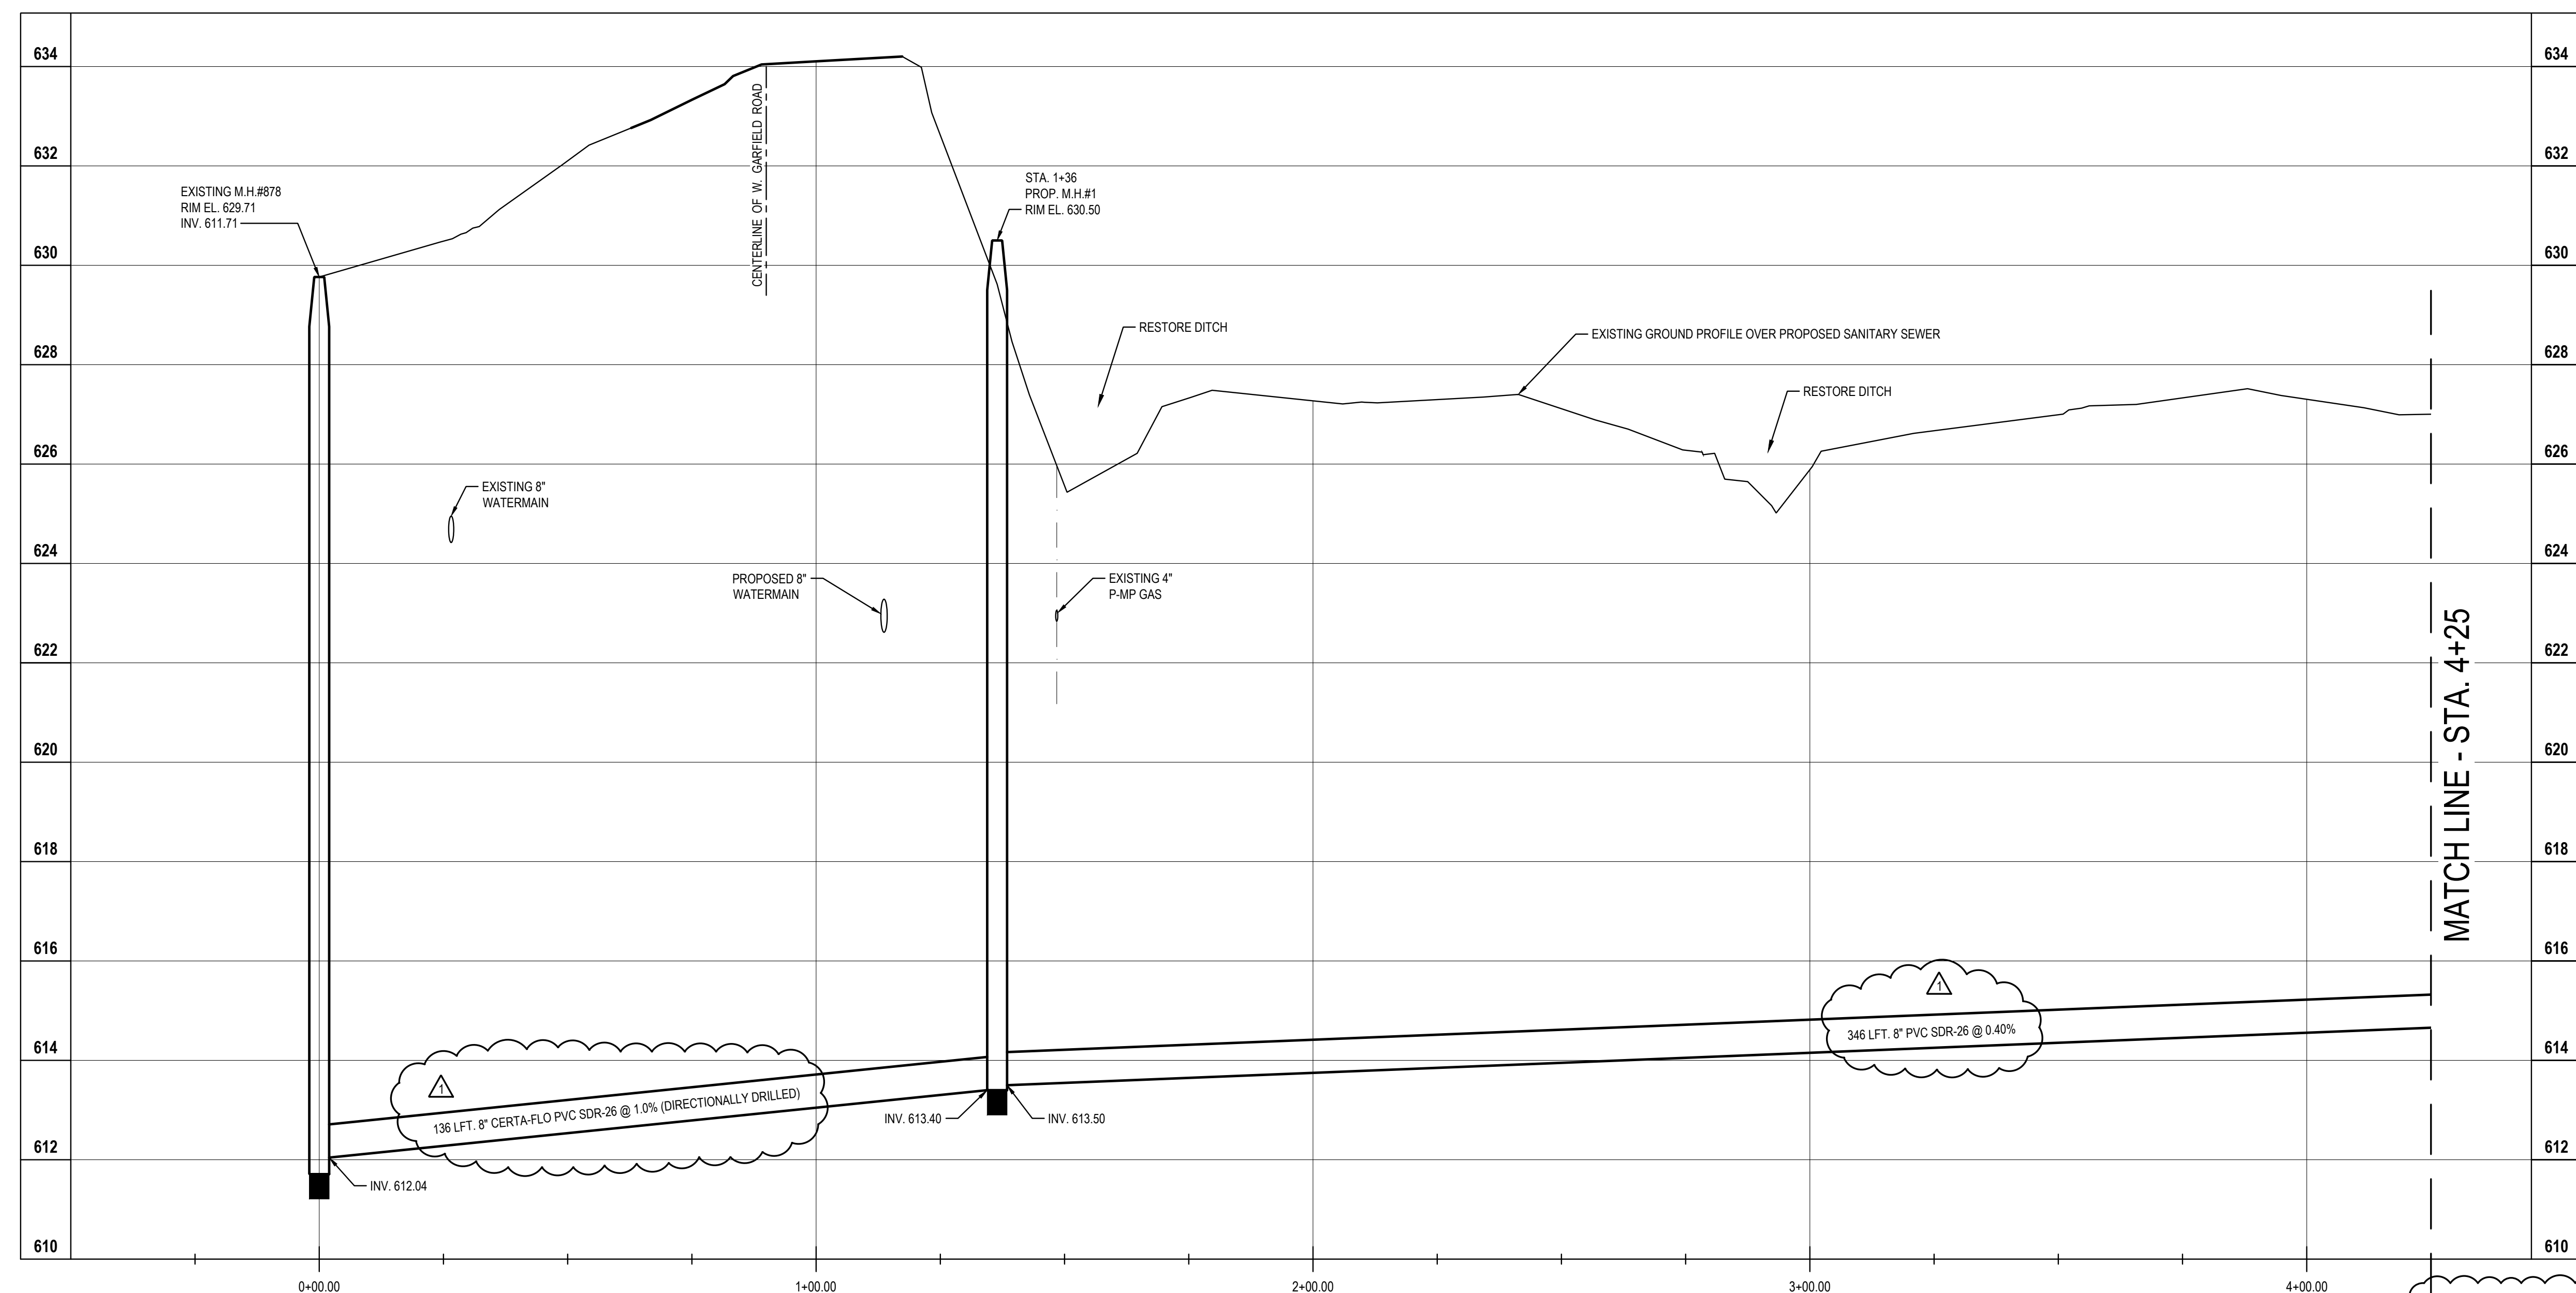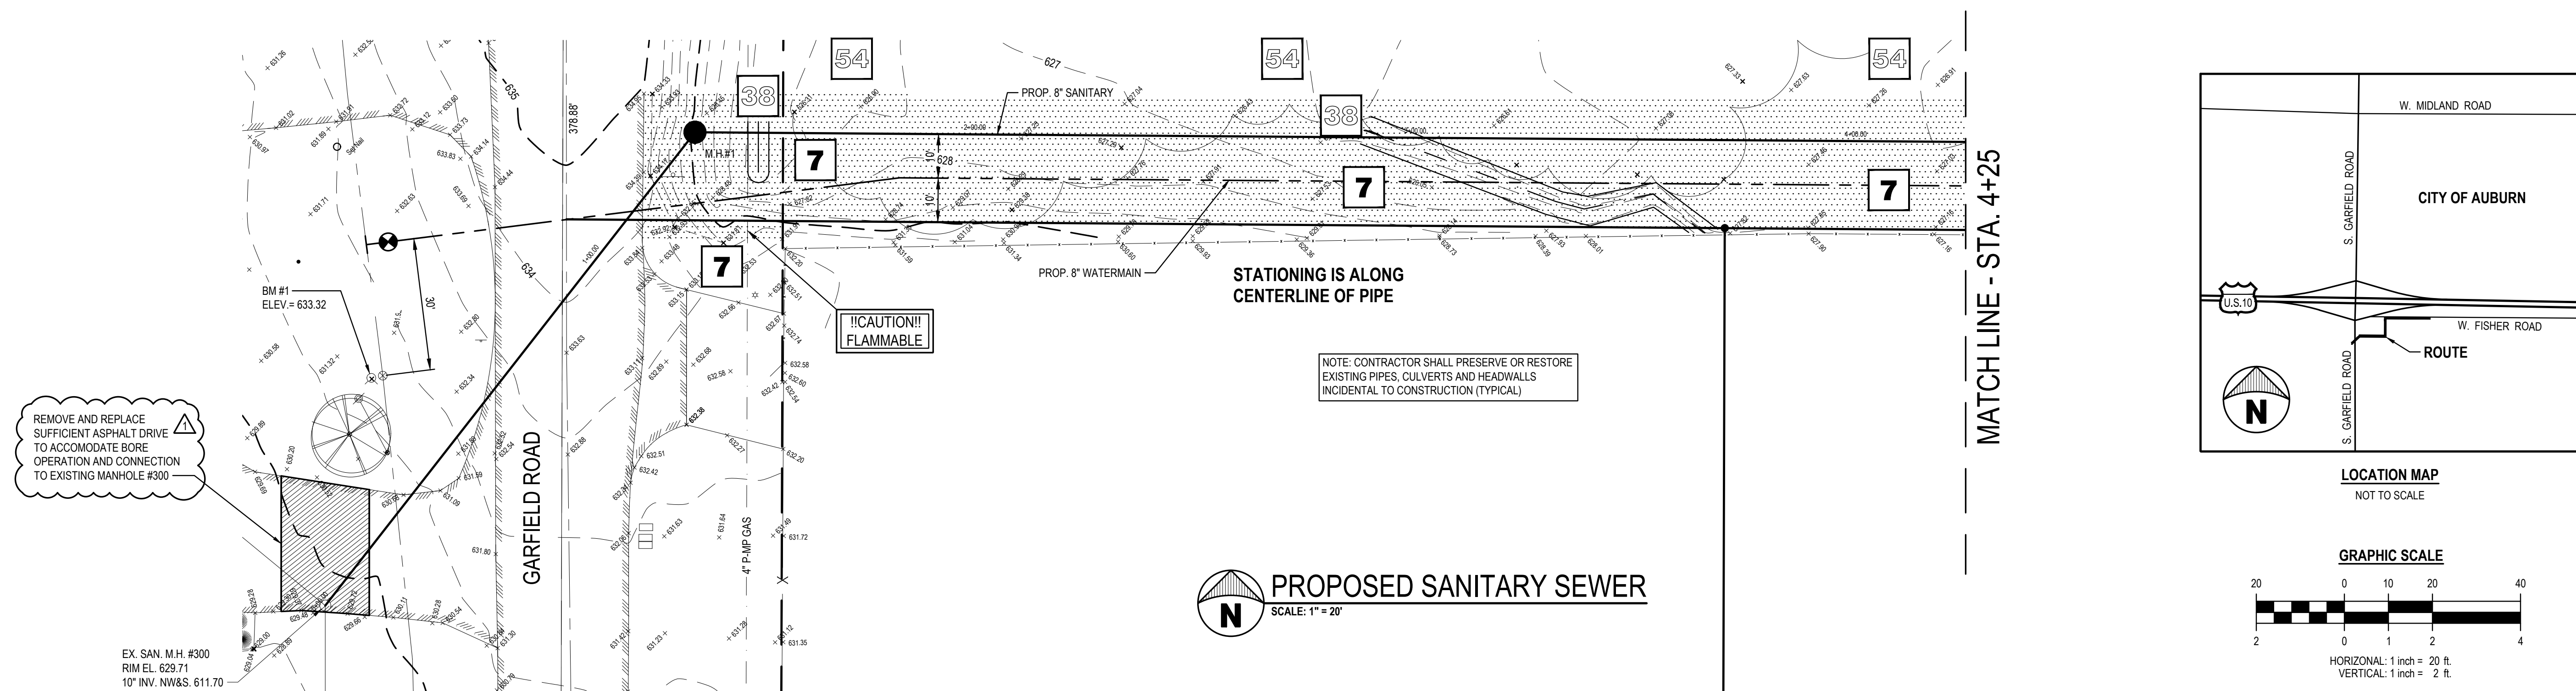[illegible]

PROFILE SCALE:
HORIZONTAL: 1" = 20'
VERTICAL: 1" = 2'

BENCHMARK

NO.1 - NORTHEAST FLANGE BOLT ON HYDRANT 44' WEST OF GARFIELD ROAD CENTERLINE
AT 5024 S. GARFIELD ROAD.
ELEVATION 633.32 (NAVD 88 DATUM)

NO.2 - NORTHEAST FLANGE BOLT ON HYDRANT 33' EAST OF GARFIELD ROAD CENTERLINE
AT PARCEL 104-026-100-025-01.
ELEVATION 627.83 (NAVD 88 DATUM)




Know what's **below**.
Call before you dig.

©2025 W&A. ALL RIGHTS RESERVED. THE DOCUMENT AND DESIGN ARE THE PROPERTY OF W&A. NO REPRODUCTION OR TRANSMISSION OF WORK IS PERMITTED UNLESS GRANTED BY W&A.



Know what's below.
Call before you dig.

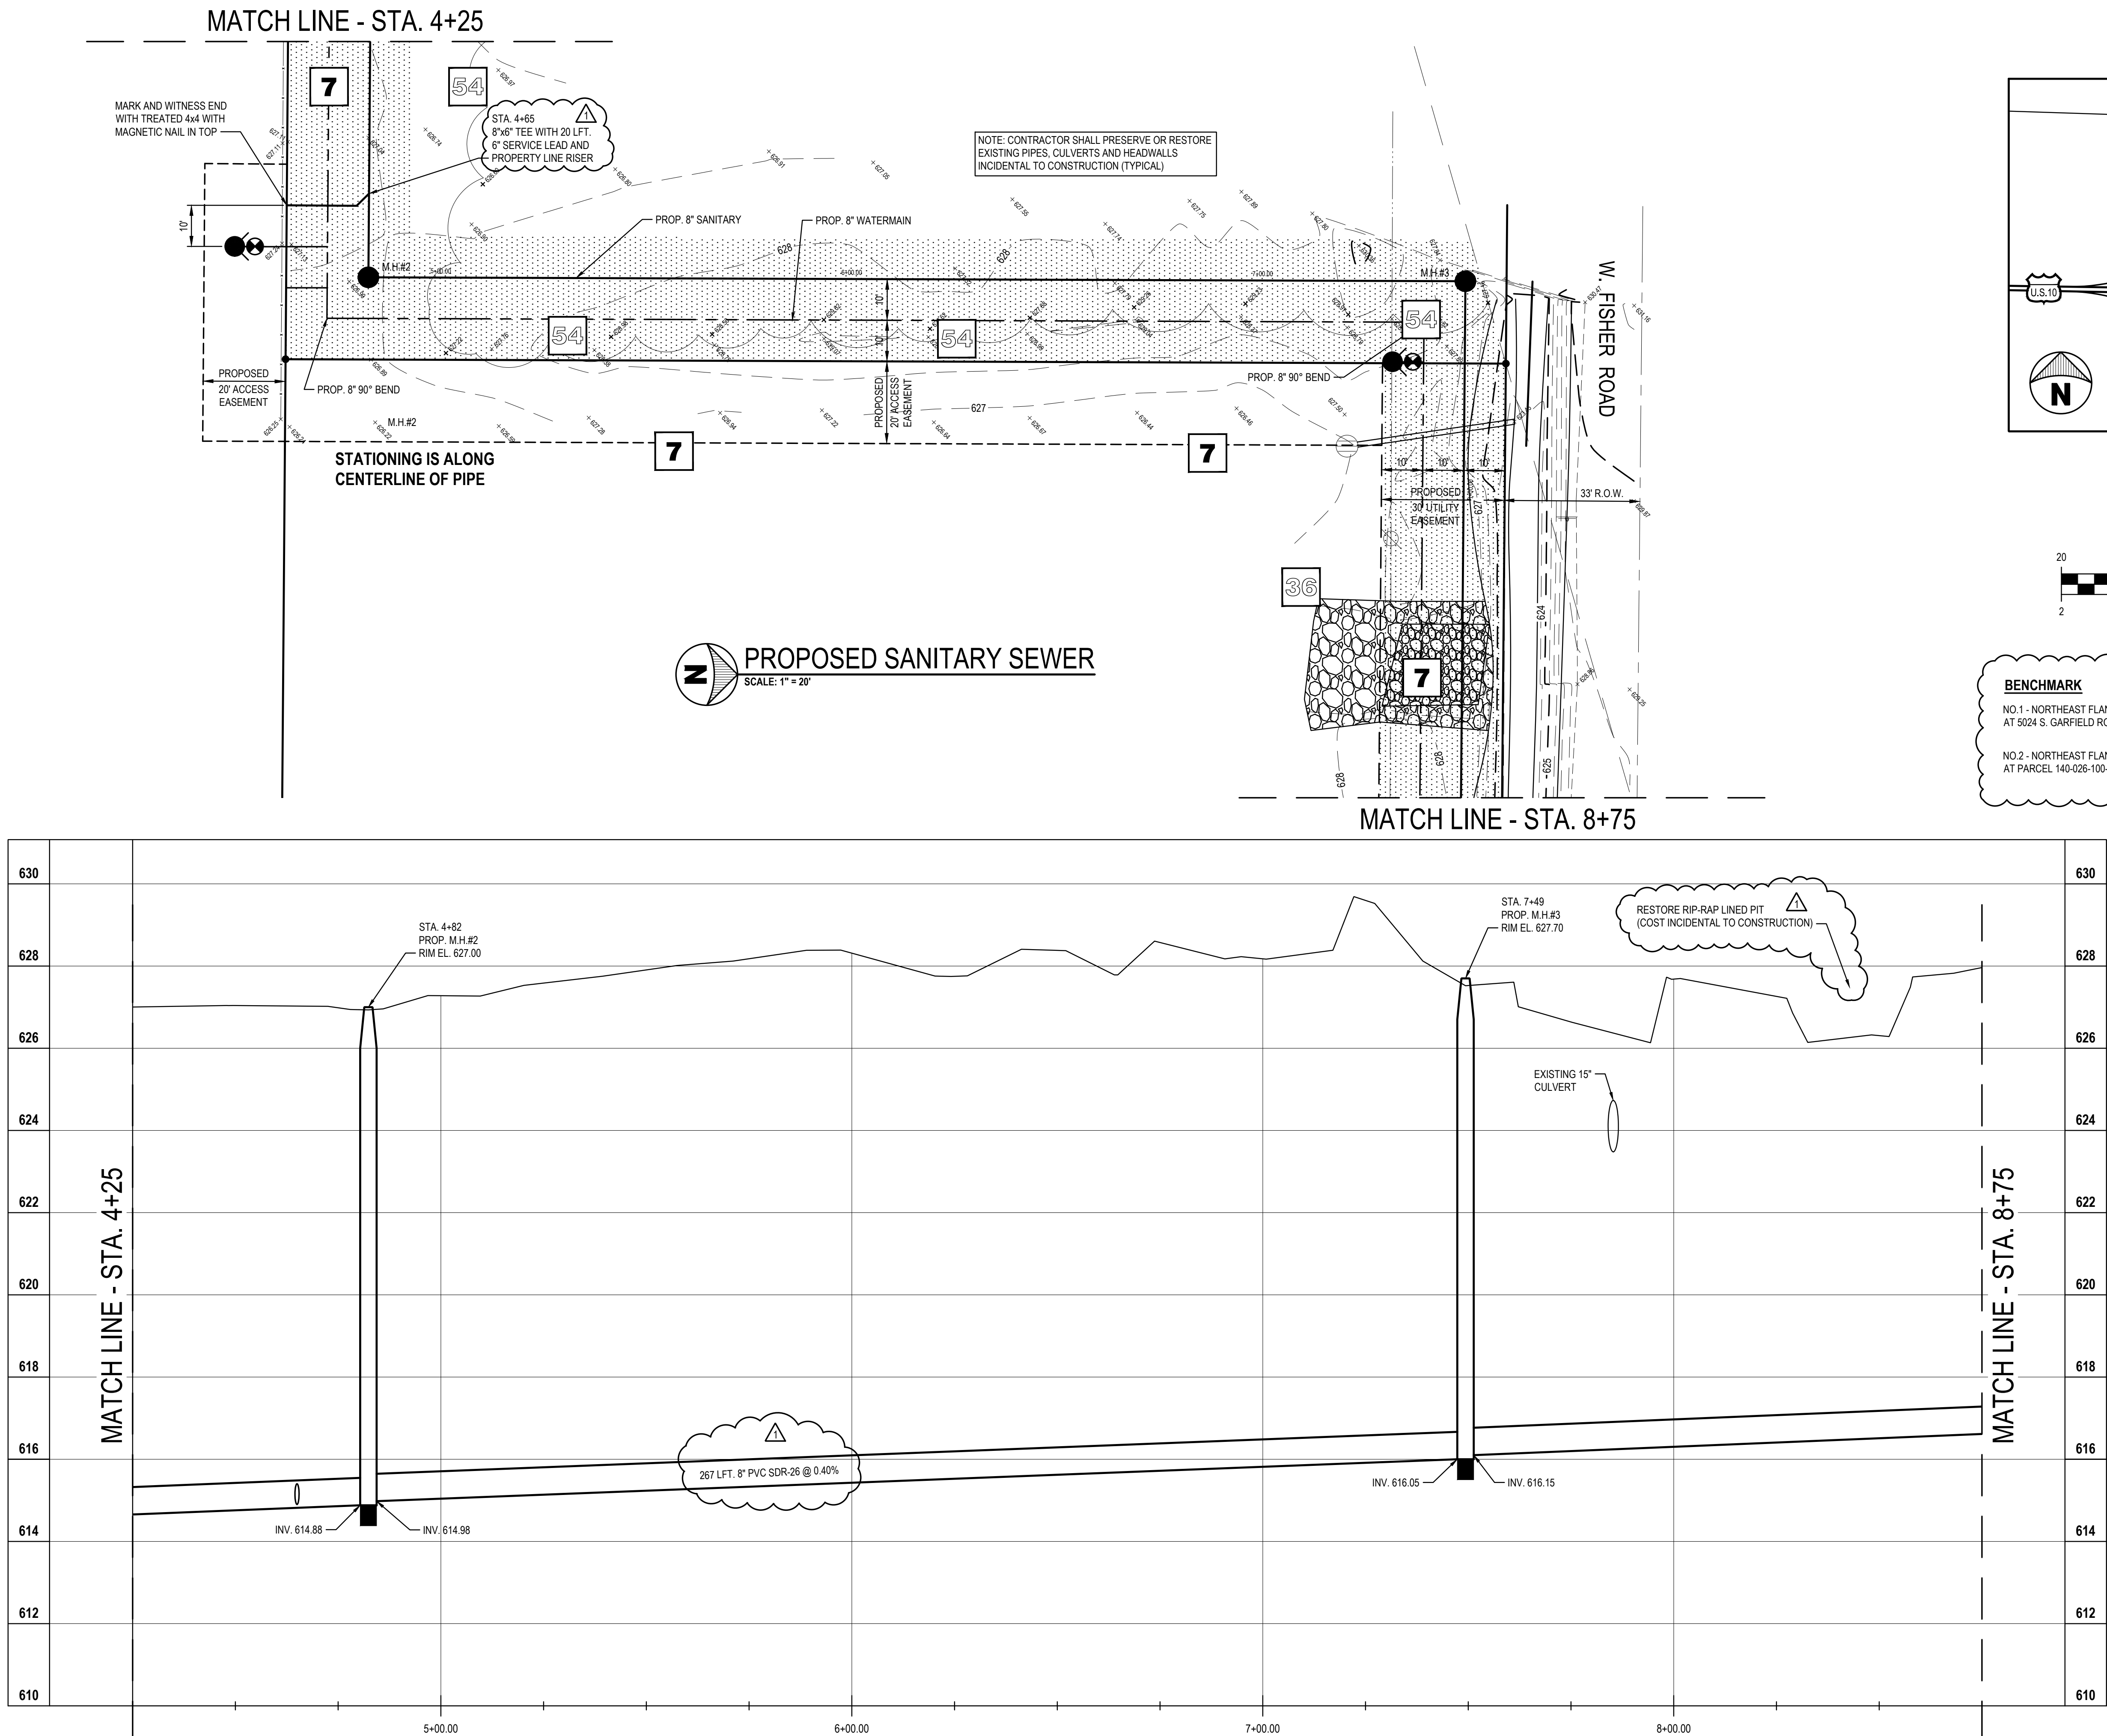

WILLIAM A. KIRBE & ASSOCIATES, INC.
ENGINEERS | ARCHITECTS | SURVEYORS

WILLIAMS CHARTER TOWNSHIP
SANITARY SEWER & WATERMAIN EXTENSION
W. FISHER ROAD
AUBURN, MI

PROPOSED SANITARY SEWER
PLAN AND PROFILE STA. 4+75 TO STA. 8+75

NO.	DATE	STATUS / REVISIONS
1	07/23/25	ISSUED FOR BIDS
	07/30/25	ADDENDUM #1

CHECKED BY:
J. WHEELER



DESIGNED BY:
D.W.BANASZAK

DRAWN BY:
D.W.BANASZAK

PROJ #: 25-1247-0021

SHEET
C4.1

PRINTED: 7/30/2025 4:17:20 PM

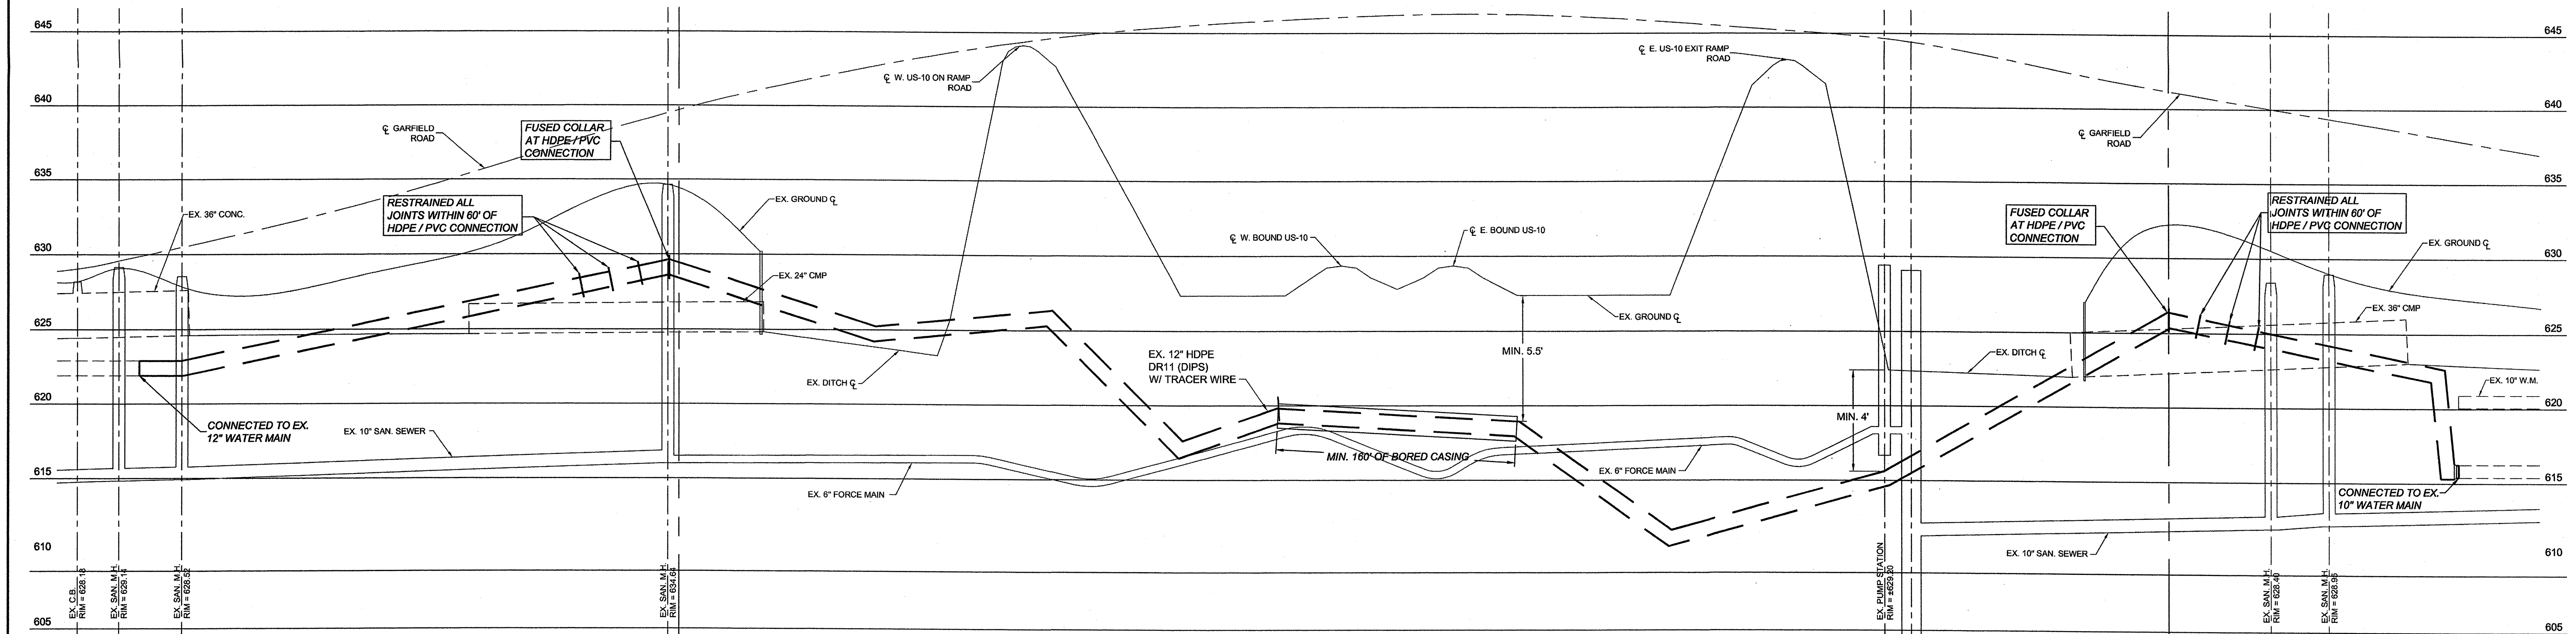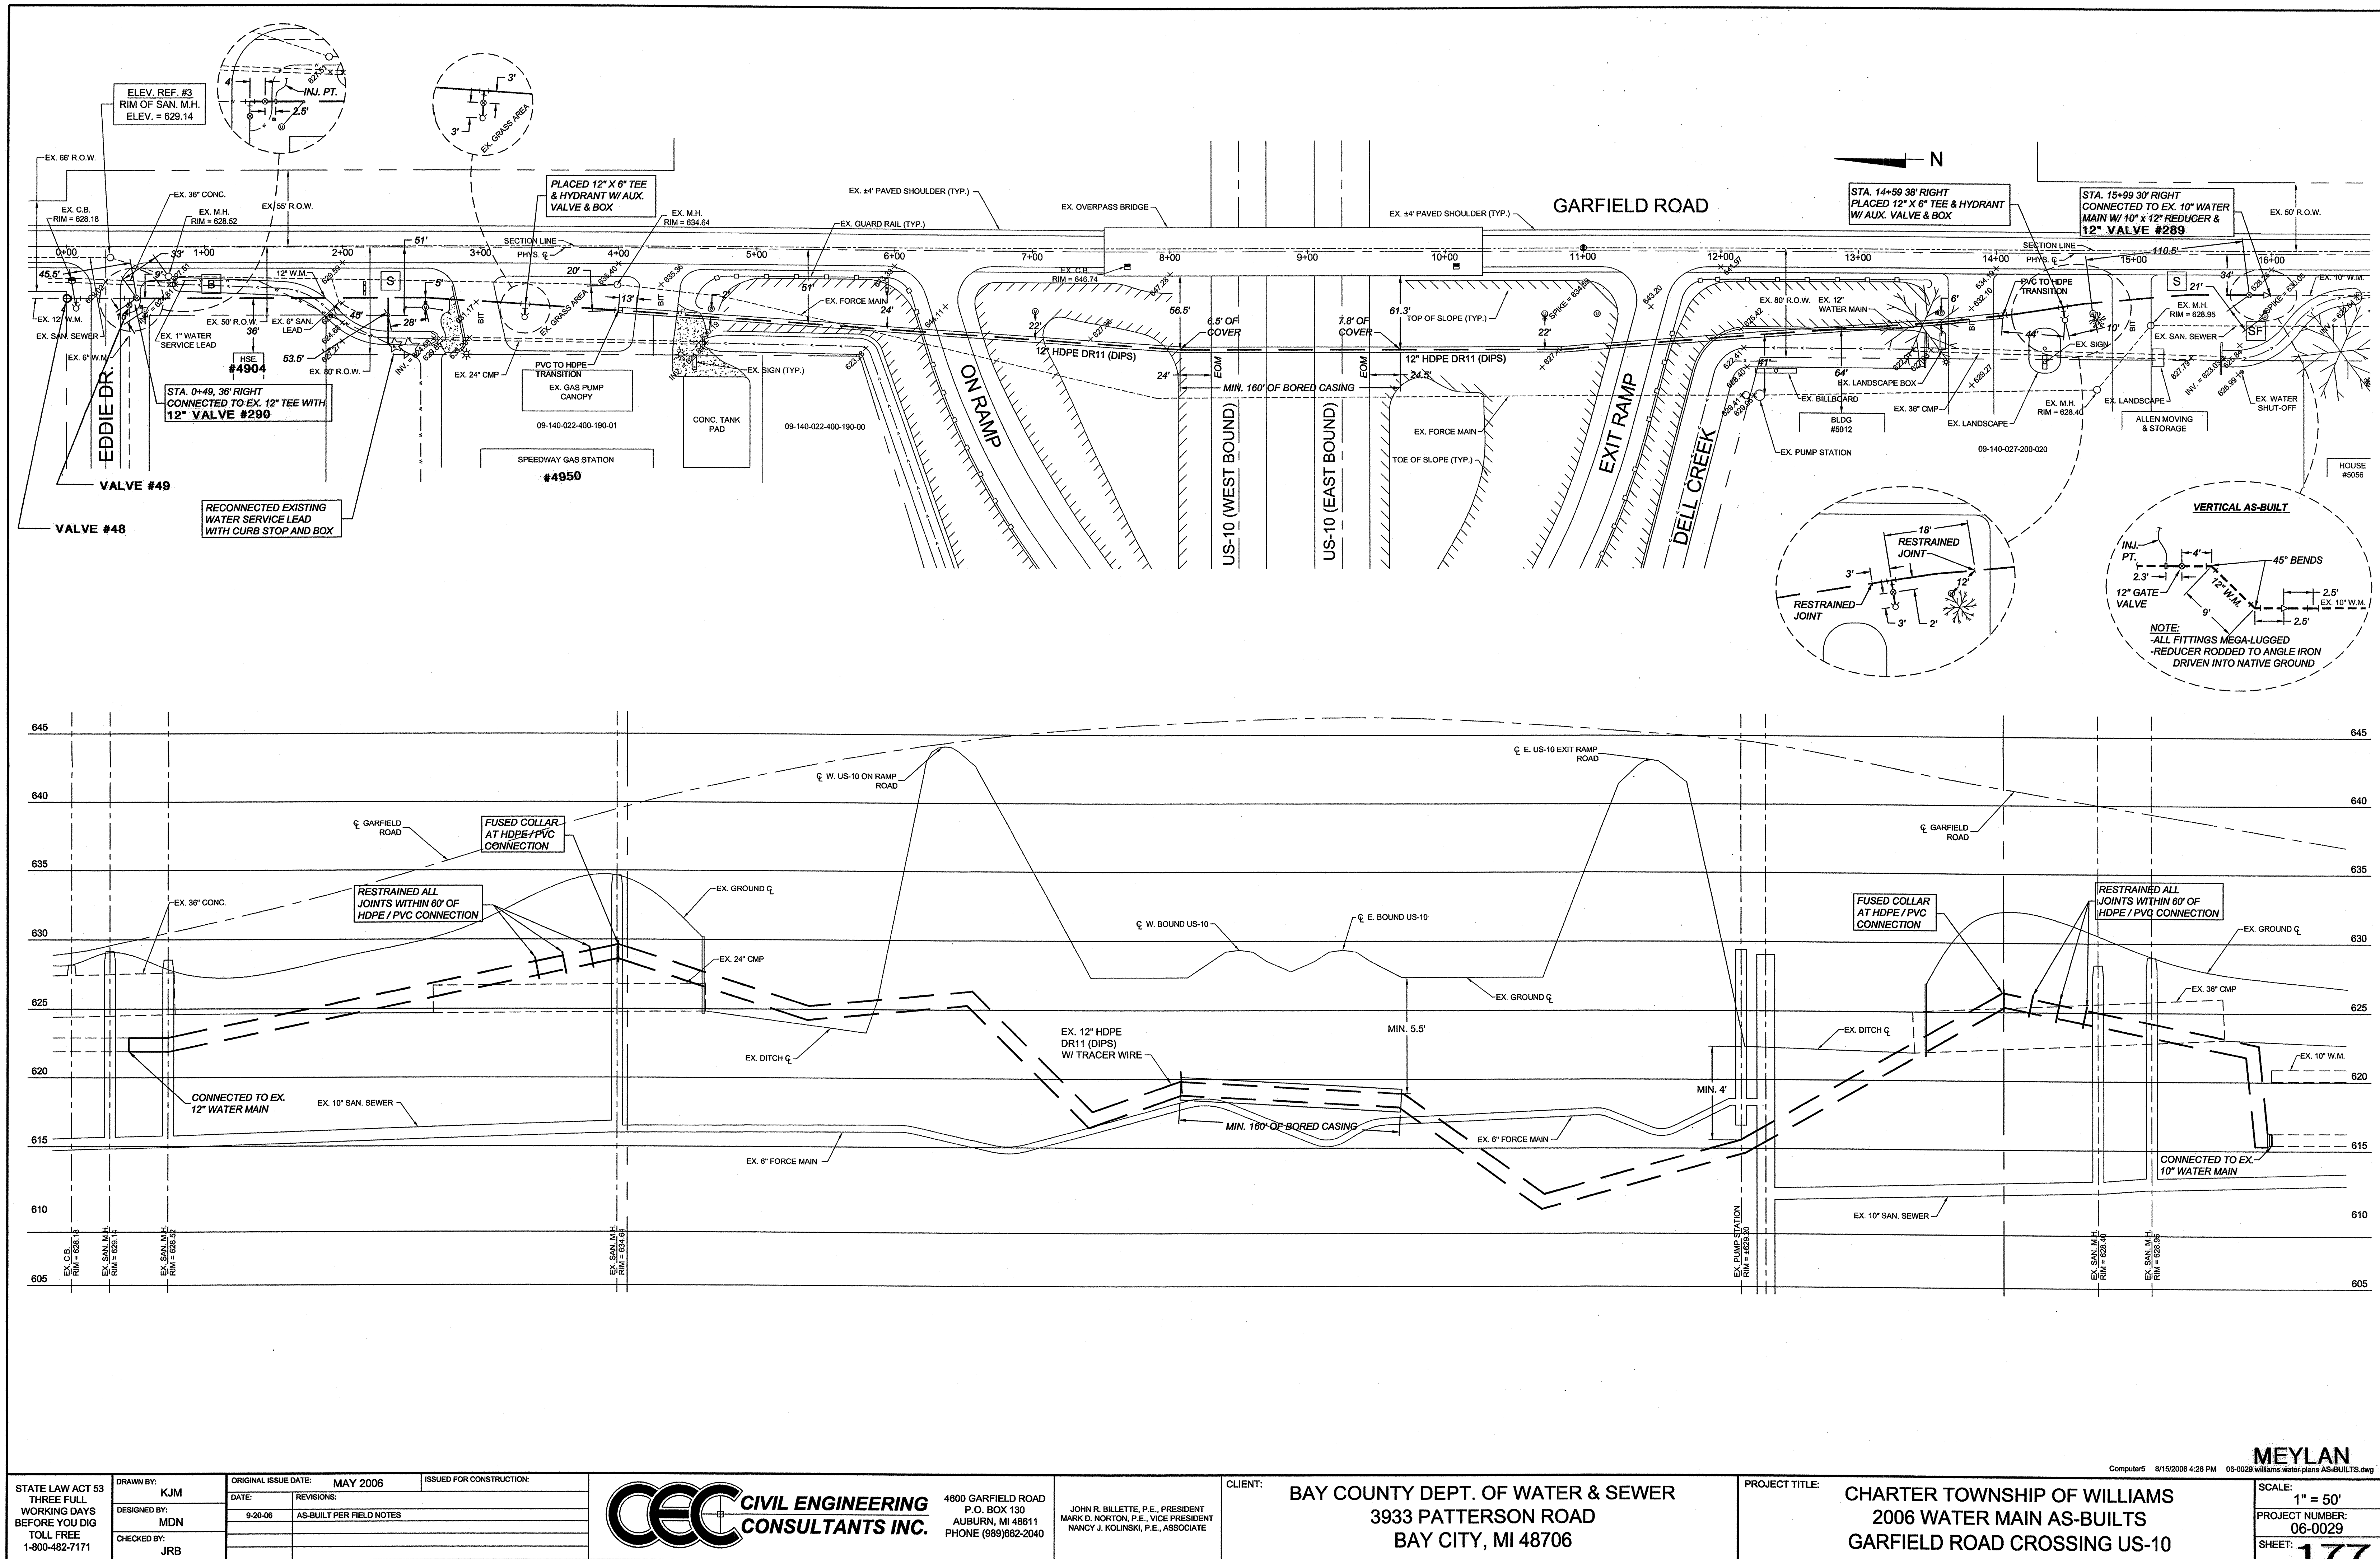

STATE LAW ACT 53 THREE FULL WORKING DAYS BEFORE YOU DIG TOLL FREE 1-800-482-7171	DRAWN BY:	KJM	ORIGINAL ISSUE DATE:	MAY 2006	ISSUED FOR CONSTRUCTION:
	DESIGNED BY:	MDN	DATE:	9-20-06	REVISIONS:
	CHECKED BY:	JRB		AS-BUILT PER FIELD NOTES	

**CIVIL ENGINEERING
CONSULTANTS INC.**

4600 GARFIELD ROAD
P.O. BOX 130
AUBURN, MI 48811
PHONE (989)662-2040

JOHN R. BILLETTE, P.E., PRESIDENT
MARK D. NORTON, P.E., VICE PRESIDENT
NANCY J. KOLINSKI, P.E., ASSOCIATE


CLIENT: **BAY COUNTY DEPT. OF WATER & SEWER**
3933 PATTERSON ROAD
BAY CITY, MI 48706

PROJECT TITLE: **CHARTER TOWNSHIP OF WILLIAMS**
2006 WATER MAIN AS-BUILTS
GARFIELD ROAD CROSSING US-10

Computer5 8/15/2006 4:28 PM 06-0028 Williams water plans AS-BUILTS.dwg

MEYLAN

SCALE: 1" = 50'
PROJECT NUMBER: 06-0029
SHEET: **177**

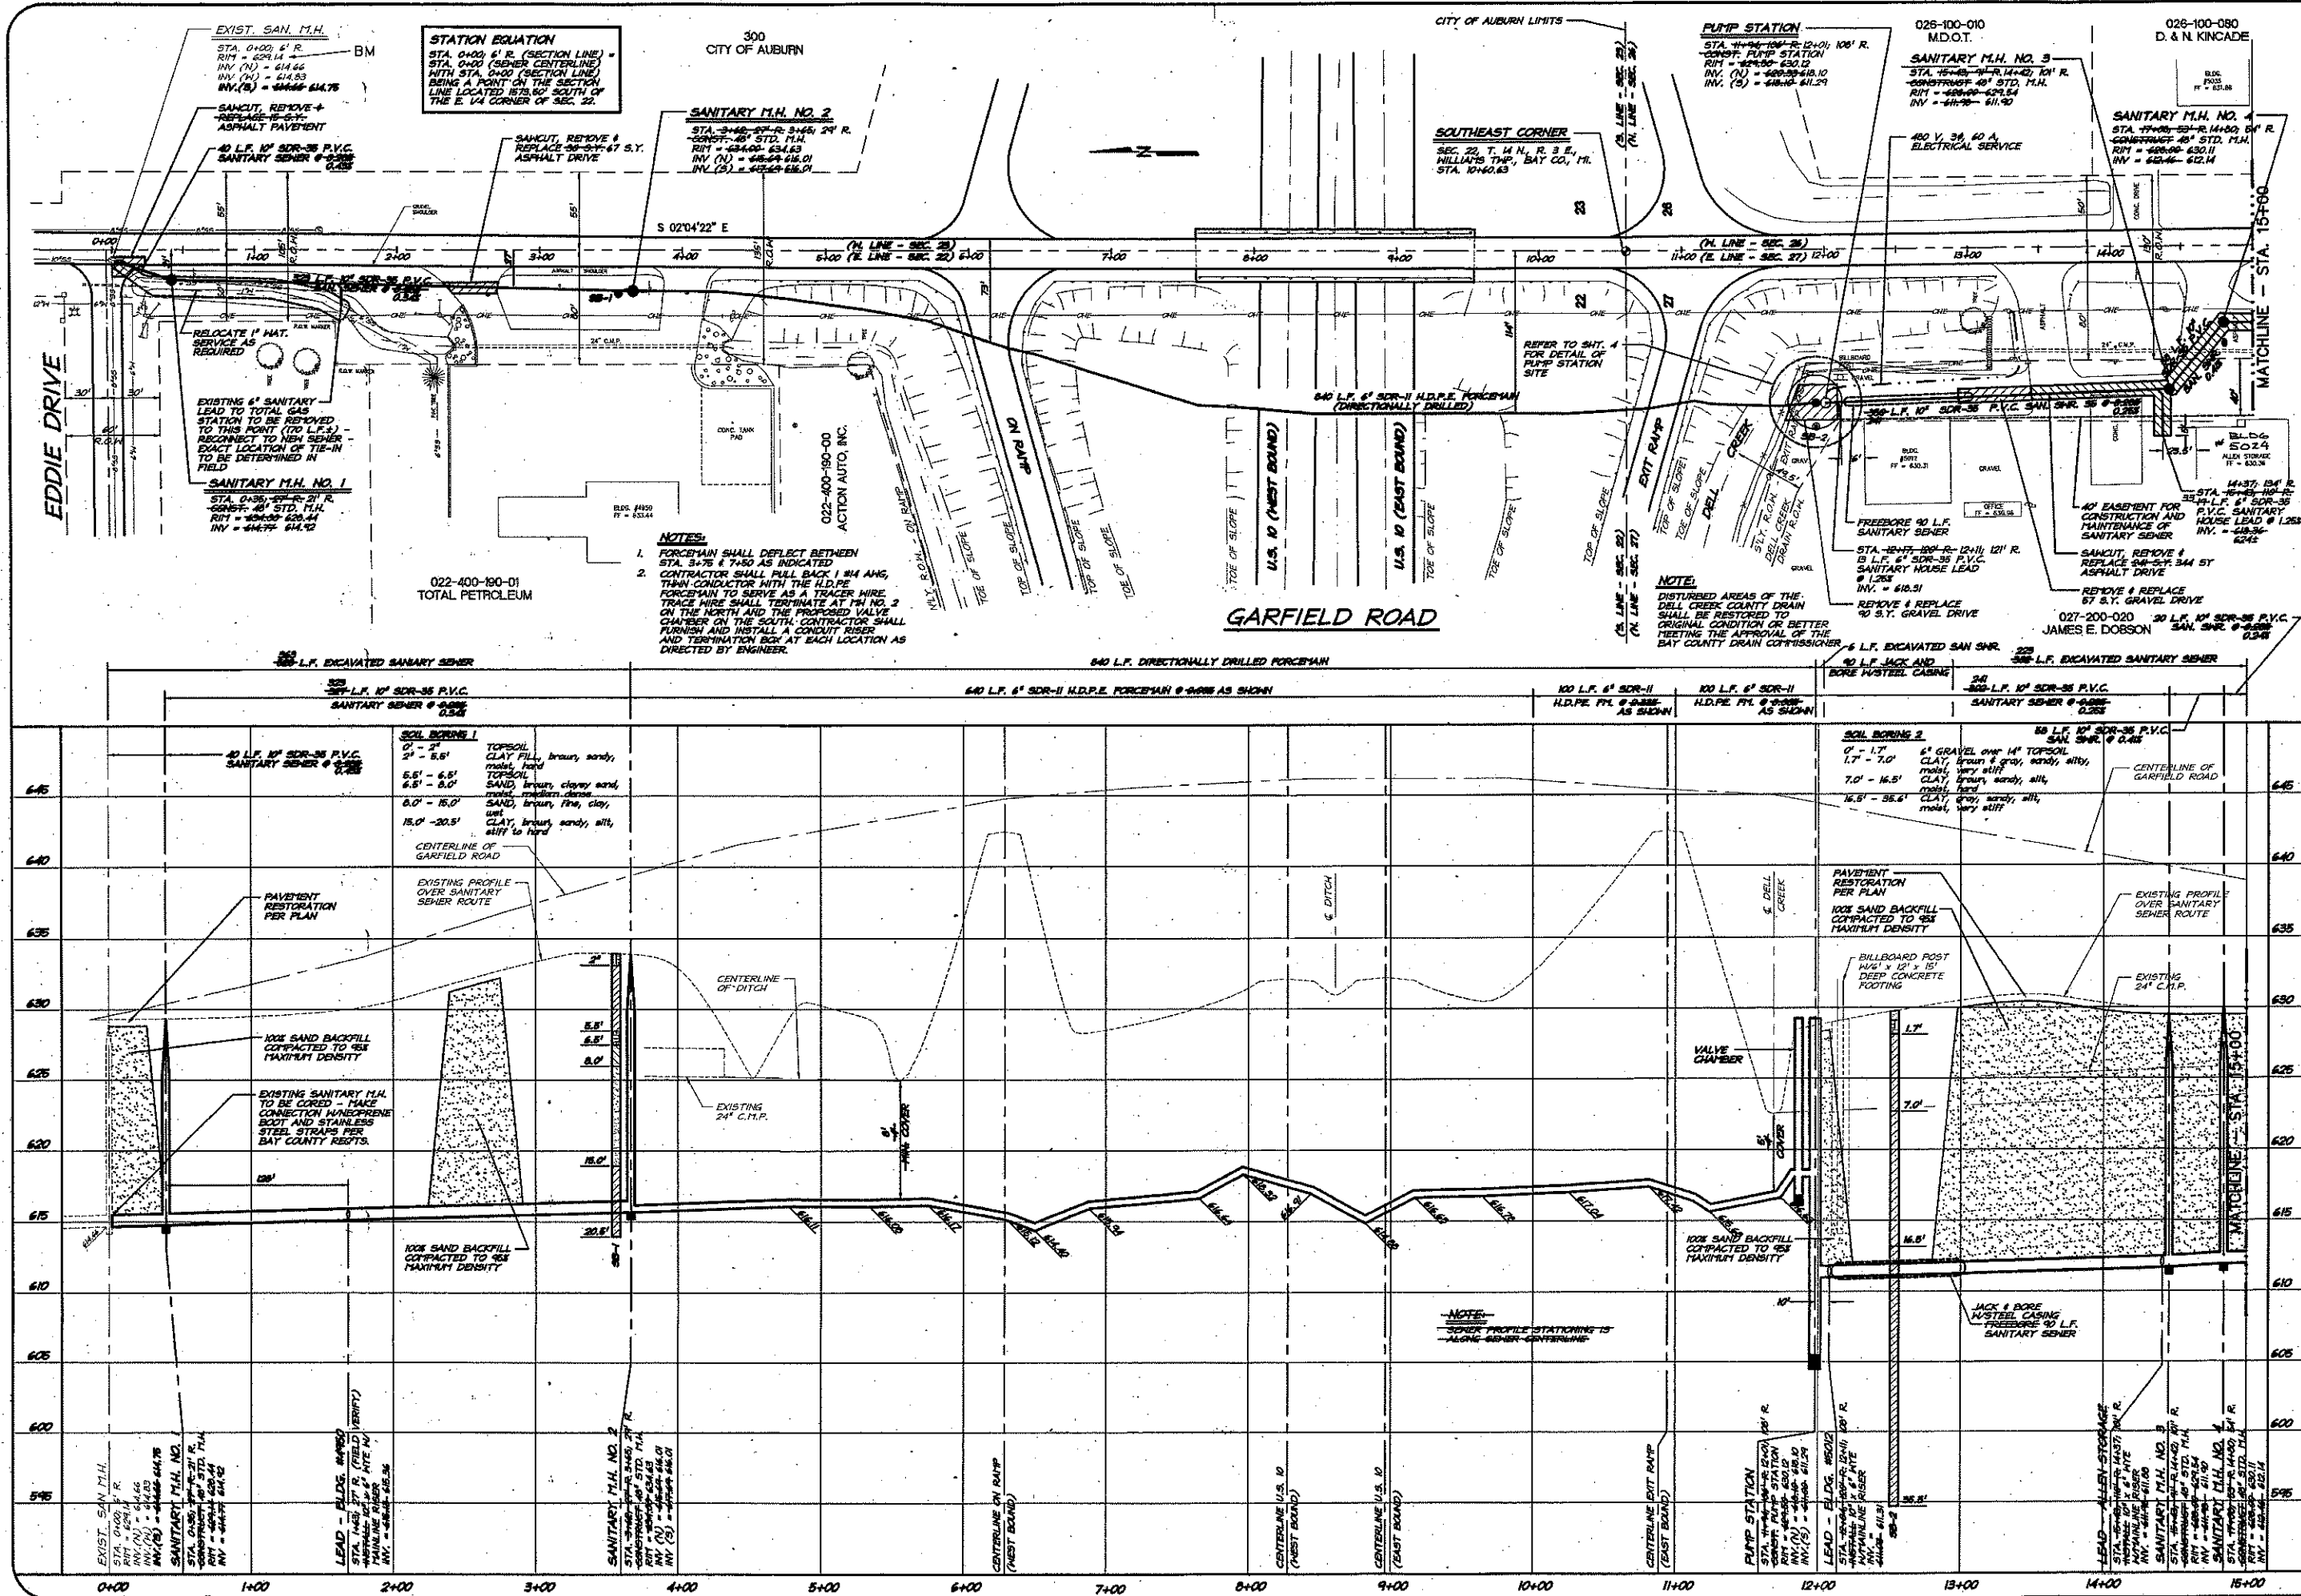

NO.	DESCRIPTION	DATE	BY
1	AS-BUILTS	5-29-98	JON
2	REVISED FORCE MAIN PER M.D.C.	6-26-97	JON
3	REVISED PER DRAIN COMMISSION	3-19-97	JAP
4			
5			


DESIGNED BY	DAP
CHECKED BY	DAP
DRAWN BY	JOB
SCALE	H. 1"=50'; V. 1"=5'
DATE	SEPTEMBER 1998
CAD FILE NO.	003655-2
JOB NO.	9800036
SHEET NO.	2

ISSUE/REVISIONS	NO.	DATE
AS-BUILTS	5-29-98	JON
REVISED FORCE MAIN PER M.D.C.	6-26-97	JON
REVISED PER DRAIN COMMISSION	3-19-97	JAP

JON LEDY P.E., P.L.C.
P.O. BOX 397
FREELAND, MICHIGAN 48823
PH. (313) 688-9570

SANITARY SEWER PLAN/PROFILE
BAY COUNTY WASTEWATER COLLECTION SYSTEM
GARFIELD ROAD SANITARY SEWER
CHARTER TOWNSHIP OF WILLIAMS
1080 WEST MIDLAND ROAD
AUBURN, MICHIGAN 48811
STA. 0+00 - STA. 15+00
EDDIE DRIVE TO 2724' SOUTH

08E108855-3 Wed Jun 16 22:36:17 1998 Jon Ludy P.E., P.L.C. - Freeland, Michigan

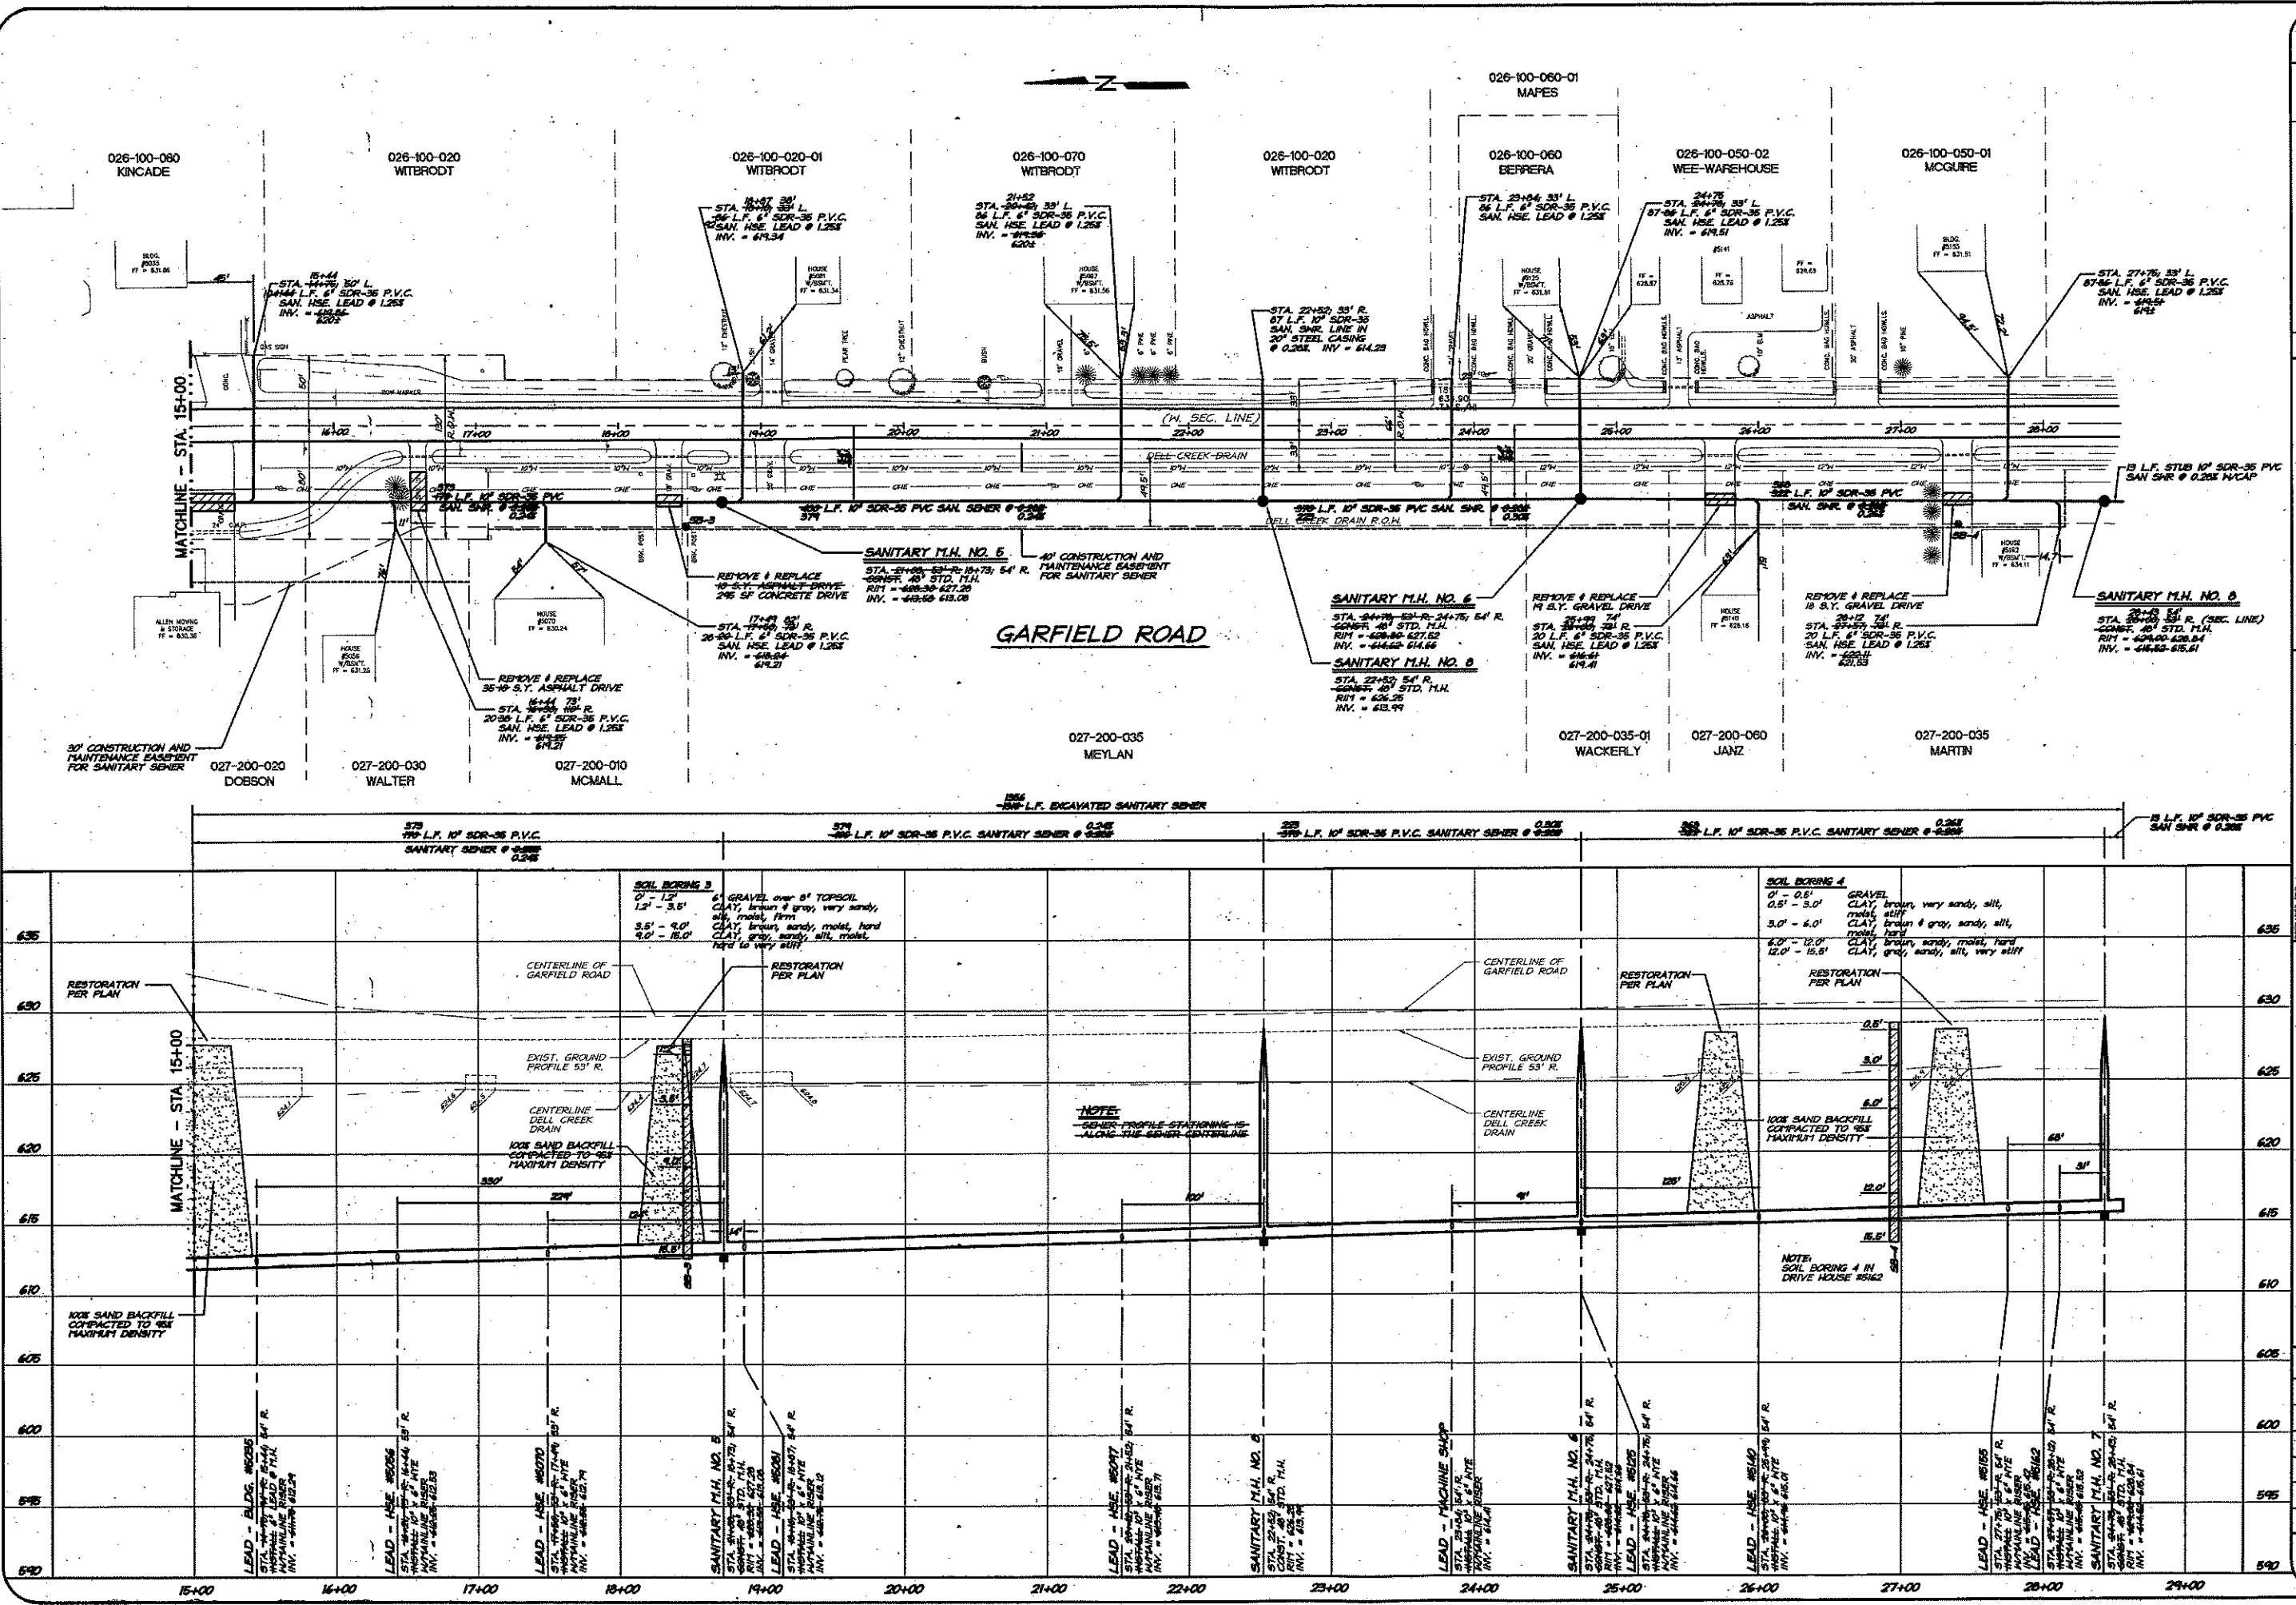

ISSUE/REVISIONS	
NO.	DESCRIPTION
1	AS-BUILT
2	REVISED PER BAY COUNTY DRAIN COM.
3	REVISED PER BAY COUNTY ROAD COM.
4	DATE
5	BY

JON LUDY P.E., P.L.C.	
PO BOX 397	
FRIELAND, MICHIGAN 48823	
(517) 685-9570	

CHARTER TOWNSHIP OF WILLIAMS	
1080 WEST MIDLAND ROAD	
AUBURN, MICHIGAN 48611	

SANITARY SEWER PLAN/PROFILE	
BAY COUNTY WASTEWATER COLLECTION SYSTEM	
GARFIELD ROAD SANITARY SEWER	
GARFIELD ROAD	
STA. 15+00 - STA. 27+24	
EDDIE DRIVE TO 2724' SOUTH	

DESIGNED BY	DAP
CHECKED BY	DAP
DRAWN BY	DOB
SCALE	H. 1"=50'; V. 1"=5'
DATE	SEPTEMBER 1998
CAD FILE NO.	003655-3
JOB NO.	980036
SHEET NO.	3